TEAM A

TEAM B

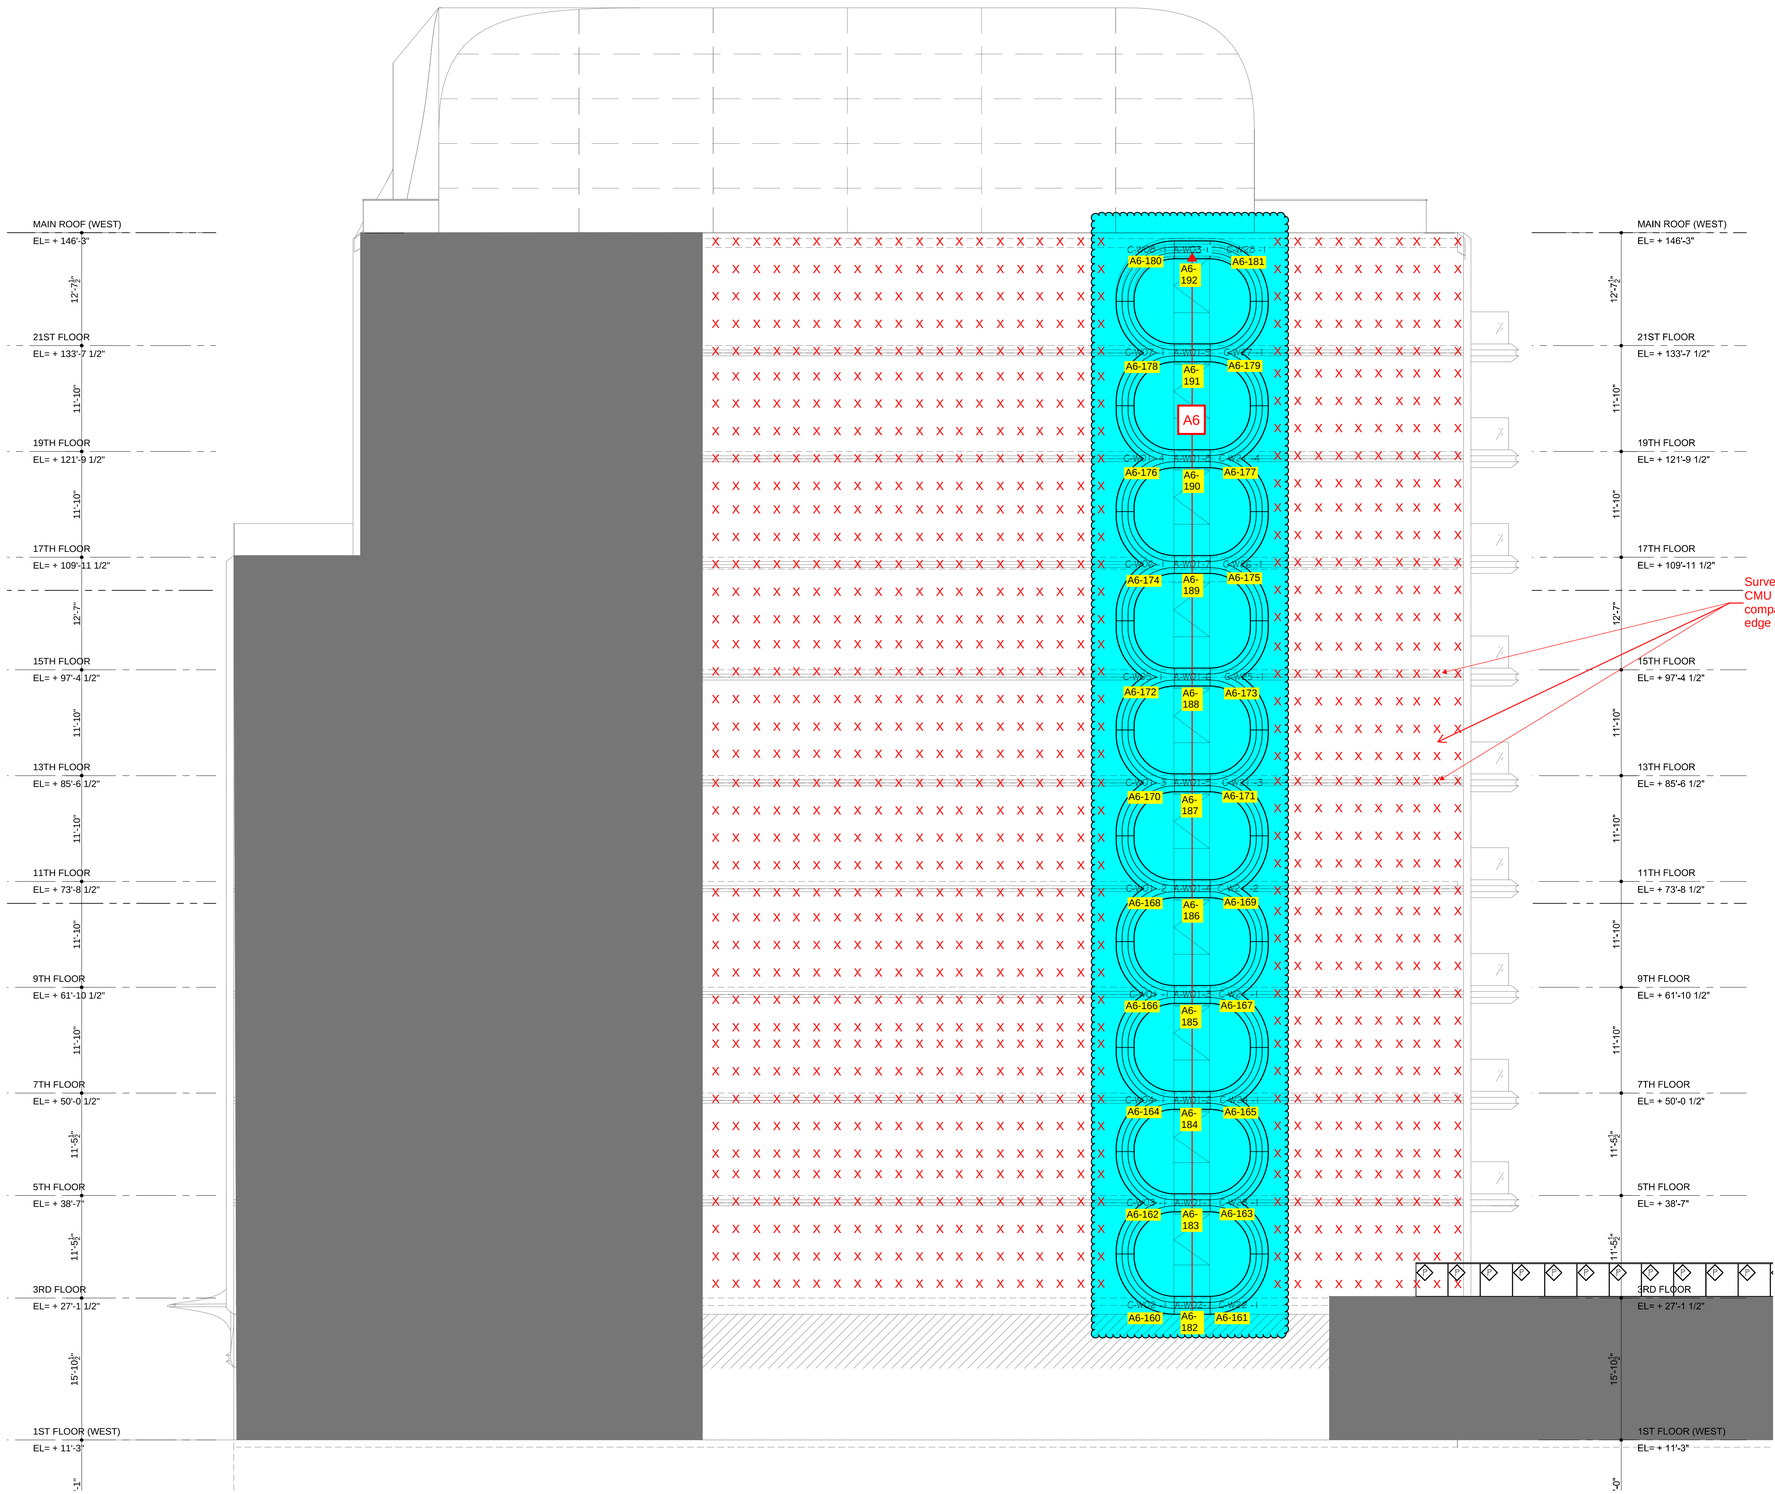

Zaha Hadid Architects

A	Reviewed Without Comments
B	Reviewed With Comments
C	Not Reviewed

Review is only for general conformance with the design intent of the Project and the information given in the Contract Documents. Contractor is responsible for dimensions to be confirmed and co-related at the job site; fabrication processes and techniques of construction; coordination of the work with all trades, and performing all work in a safe and satisfactory manner. This approval does not modify the Contractor's duty to comply with the Contract Documents.

Reviewed by: Date:

ISMAEL LEYVA ARCHITECTS, P.C.

NO EXCEPTIONS TAKEN	REVISE & RESUBMIT
MAKE CORRECTIONS NOTED	REJECTED
SUBMIT REV. RECORD COPY	REVIEWED

Corrections or comments made on the shop drawings during this review do not relieve the contractor from compliance with requirements of the drawings and specifications. This check is only for review of general conformance with the design concept of the project and general documents. The contractor is responsible for confirming and correlating all quantities and dimensions, selecting fabrication processes and techniques of construction, coordinating his work with that of all other trades, and performing his work in safe and and satisfactory manner.

Project No: By: Date:

Gilsanz Murray Steficek, LLP

129 w. 27th Street, New York, NY 10001
Tel: 212-254-0030 Fax: 212-477-5978

Reviewed With Comments	
Reviewed Without Comments	
Not Reviewed	

Review is for conformance with design concept and with information in Contract Documents. Contractor is responsible for confirming and correlating dimensions and quantities, for fabrication methods and for coordination with work of other trades. Review by GMS is in addition to review by Architect, Engineers or parties of record. GMS refers to the Architect for aesthetic review and coordination with all related work.

By _____ Date _____

DESIMONE CONSULTING ENGINEERS

No Exception Taken	
Make Corrections Noted, No Resubmission Required	
Make Corrections Noted, Submit Revised Record Copy	
Revise and Resubmit	
Reyected - See Remarks	

Review of drawings and/or calculations for pre-engineered products of systems is solely to ascertain that loads, deflection limits, and other design criteria given in Contract Documents have been utilized and to review effect of loads imposed by such products on the primary structure. The engineer retained by the supplier is solely responsible for preparing calculations, reviewing shop drawings, and ensuring the compatibility of the product with the primary building structure as it relates to their design intent. Neither this stamp nor any comments made by DeSimone authorizes changes to the Contract Documents. DeSimone's review does not indicate approval of an assembly of which the reviewed item is a component.

By _____ Date _____

RECORD OF PRINTS

DATE	QUANT.	TO	FOR

REVISIONS

DATE	REVISION / ISSUE

PROJECT: W. 28th Street Residential
LOCATION: 520 W. 28th St., New York City, NY 10001
ARCHITECT: Zaha Hadid Architects / ILA Architects
CONTRACTOR: Related Companies
DRAWING TITLE: WEST ELEVATION

M. COHEN & SONS, THE IRON SHOP
400 REED ROAD
BROOMALL, PA 19008
PHONE: 610-544-7100 FAX: 610-544-4956

DATE: 6/29/15
DRAWN BY: ReNeT
CHECKED BY: AS/CN
SCALE: 1/8" = 1'-0"
PROJECT NUMBER: 13MC0677
SCOPE ITEM: 1-9
DRAWING NUMBER: MC-244

NO PART OF THIS DRAWING MAY BE USED WITH BUILDING PURPOSE, CIRCULATED OR REPRODUCED IN ANY FORM OR INCORPORATED INTO ANY INFORMATION SYSTEM, ELECTRICAL OR MECHANICAL, WITHOUT WRITTEN CONSENT OF THE COPYRIGHT OWNER.